

METRIC: DISTANCES SHOWN
ON THIS PLAN ARE IN METRES
AND CAN BE CONVERTED TO
FEET BY DIVIDING BY 0.3048.

EUCLID STREET

(DEDICATED BY REGISTERED PLAN I90)

SURVEYOR'S REAL PROPERTY REPORT
PART 1
PLAN SHOWING
PART OF LOT 21
REGISTERED PLAN I90
CITY OF MARKHAM
REGIONAL MUNICIPALITY OF YORK

SCALE : 1:200



© COPYRIGHT SCHAEFFER DZALDOV BENNETT LTD.

SURVEYOR'S REAL PROPERTY REPORT
PART 2

THIS PLAN MUST BE READ WITH SURVEYOR'S REAL PROPERTY
REPORT DATED MAY 3, 2013.

NOTES

■	DENOTES	FOUND MONUMENT
□	"	PLANTED MONUMENT
SIB	"	STANDARD IRON BAR
SSIB	"	SHORT STANDARD IRON BAR
IB	"	IRON BAR
P	"	REGISTERED PLAN I90
P1	"	PLAN 65R-19327
P2	"	PLAN BY R.G. MCKIBBON LIMITED, DATED SEPTEMBER 14, 2011
P3	"	PLAN BY R.G. MCKIBBON LIMITED, DATED APRIL 26, 2007
I137	"	R.G. MCKIBBON, O.L.S.
I042	"	B.K. EDWARDS, O.L.S.
H&J	"	HOLDING & JONES, O.L.S.
BF	"	BOARD FENCE
RF	"	RAIL FENCE
ILS	"	INTERLOCKING STONE
M	"	MEASURED
OW	"	OVERHEAD WIRES
UP	"	UTILITY POLE
WIT	"	WITNESS

BEARINGS HEREON ARE ASTRONOMIC AND ARE REFERRED TO THE NORTHERLY
LIMIT OF PAVILLION STREET AS SHOWN ON PLAN 65R-19327 HAVING A
BEARING OF N72°14'20"E.

THIS REPORT WAS PREPARED FOR TEMPLAR TRINAISTICH & ERICA JOAN TSANG
AND OTHER APPLICABLE PARTIES TO CURRENT TRANSACTIONS ONLY,
AND THE UNDERSIGNED IS NOT LIABLE FOR ANY FUTURE TRANSACTIONS.

ASSOCIATION OF ONTARIO
LAND SURVEYORS
PLAN SUBMISSION FORM
1849992



THIS PLAN IS NOT VALID
UNLESS IT IS AN EMBOSSED
ORIGINAL COPY
ISSUED BY THE SURVEYOR
In accordance with
Regulation 1026, Section 29(3).

SURVEYOR'S CERTIFICATE

I CERTIFY THAT :

1. THIS SURVEY AND PLAN ARE CORRECT AND IN ACCORDANCE WITH THE
SURVEYS ACT, THE SURVEYORS ACT AND THE REGULATIONS MADE
UNDER THEM.

2. THE SURVEY WAS COMPLETED ON THE 1st DAY OF MAY, 2013.

DATE: MAY 3, 2013.

DAN DZALDOV
ONTARIO LAND SURVEYOR




SCHAEFFER DZALDOV BENNETT LTD.
ONTARIO LAND SURVEYORS

64 JARDIN DRIVE CONCORD, ONTARIO L4K 3P3 TEL.(416)987-0101

DRAWN SB CHECKED WMF SCALE 1:200 JOB NO. I3-I15-00A

EUREKA STREET
(DEDICATED BY REGISTERED PLAN I90)
PIN 02987-0160

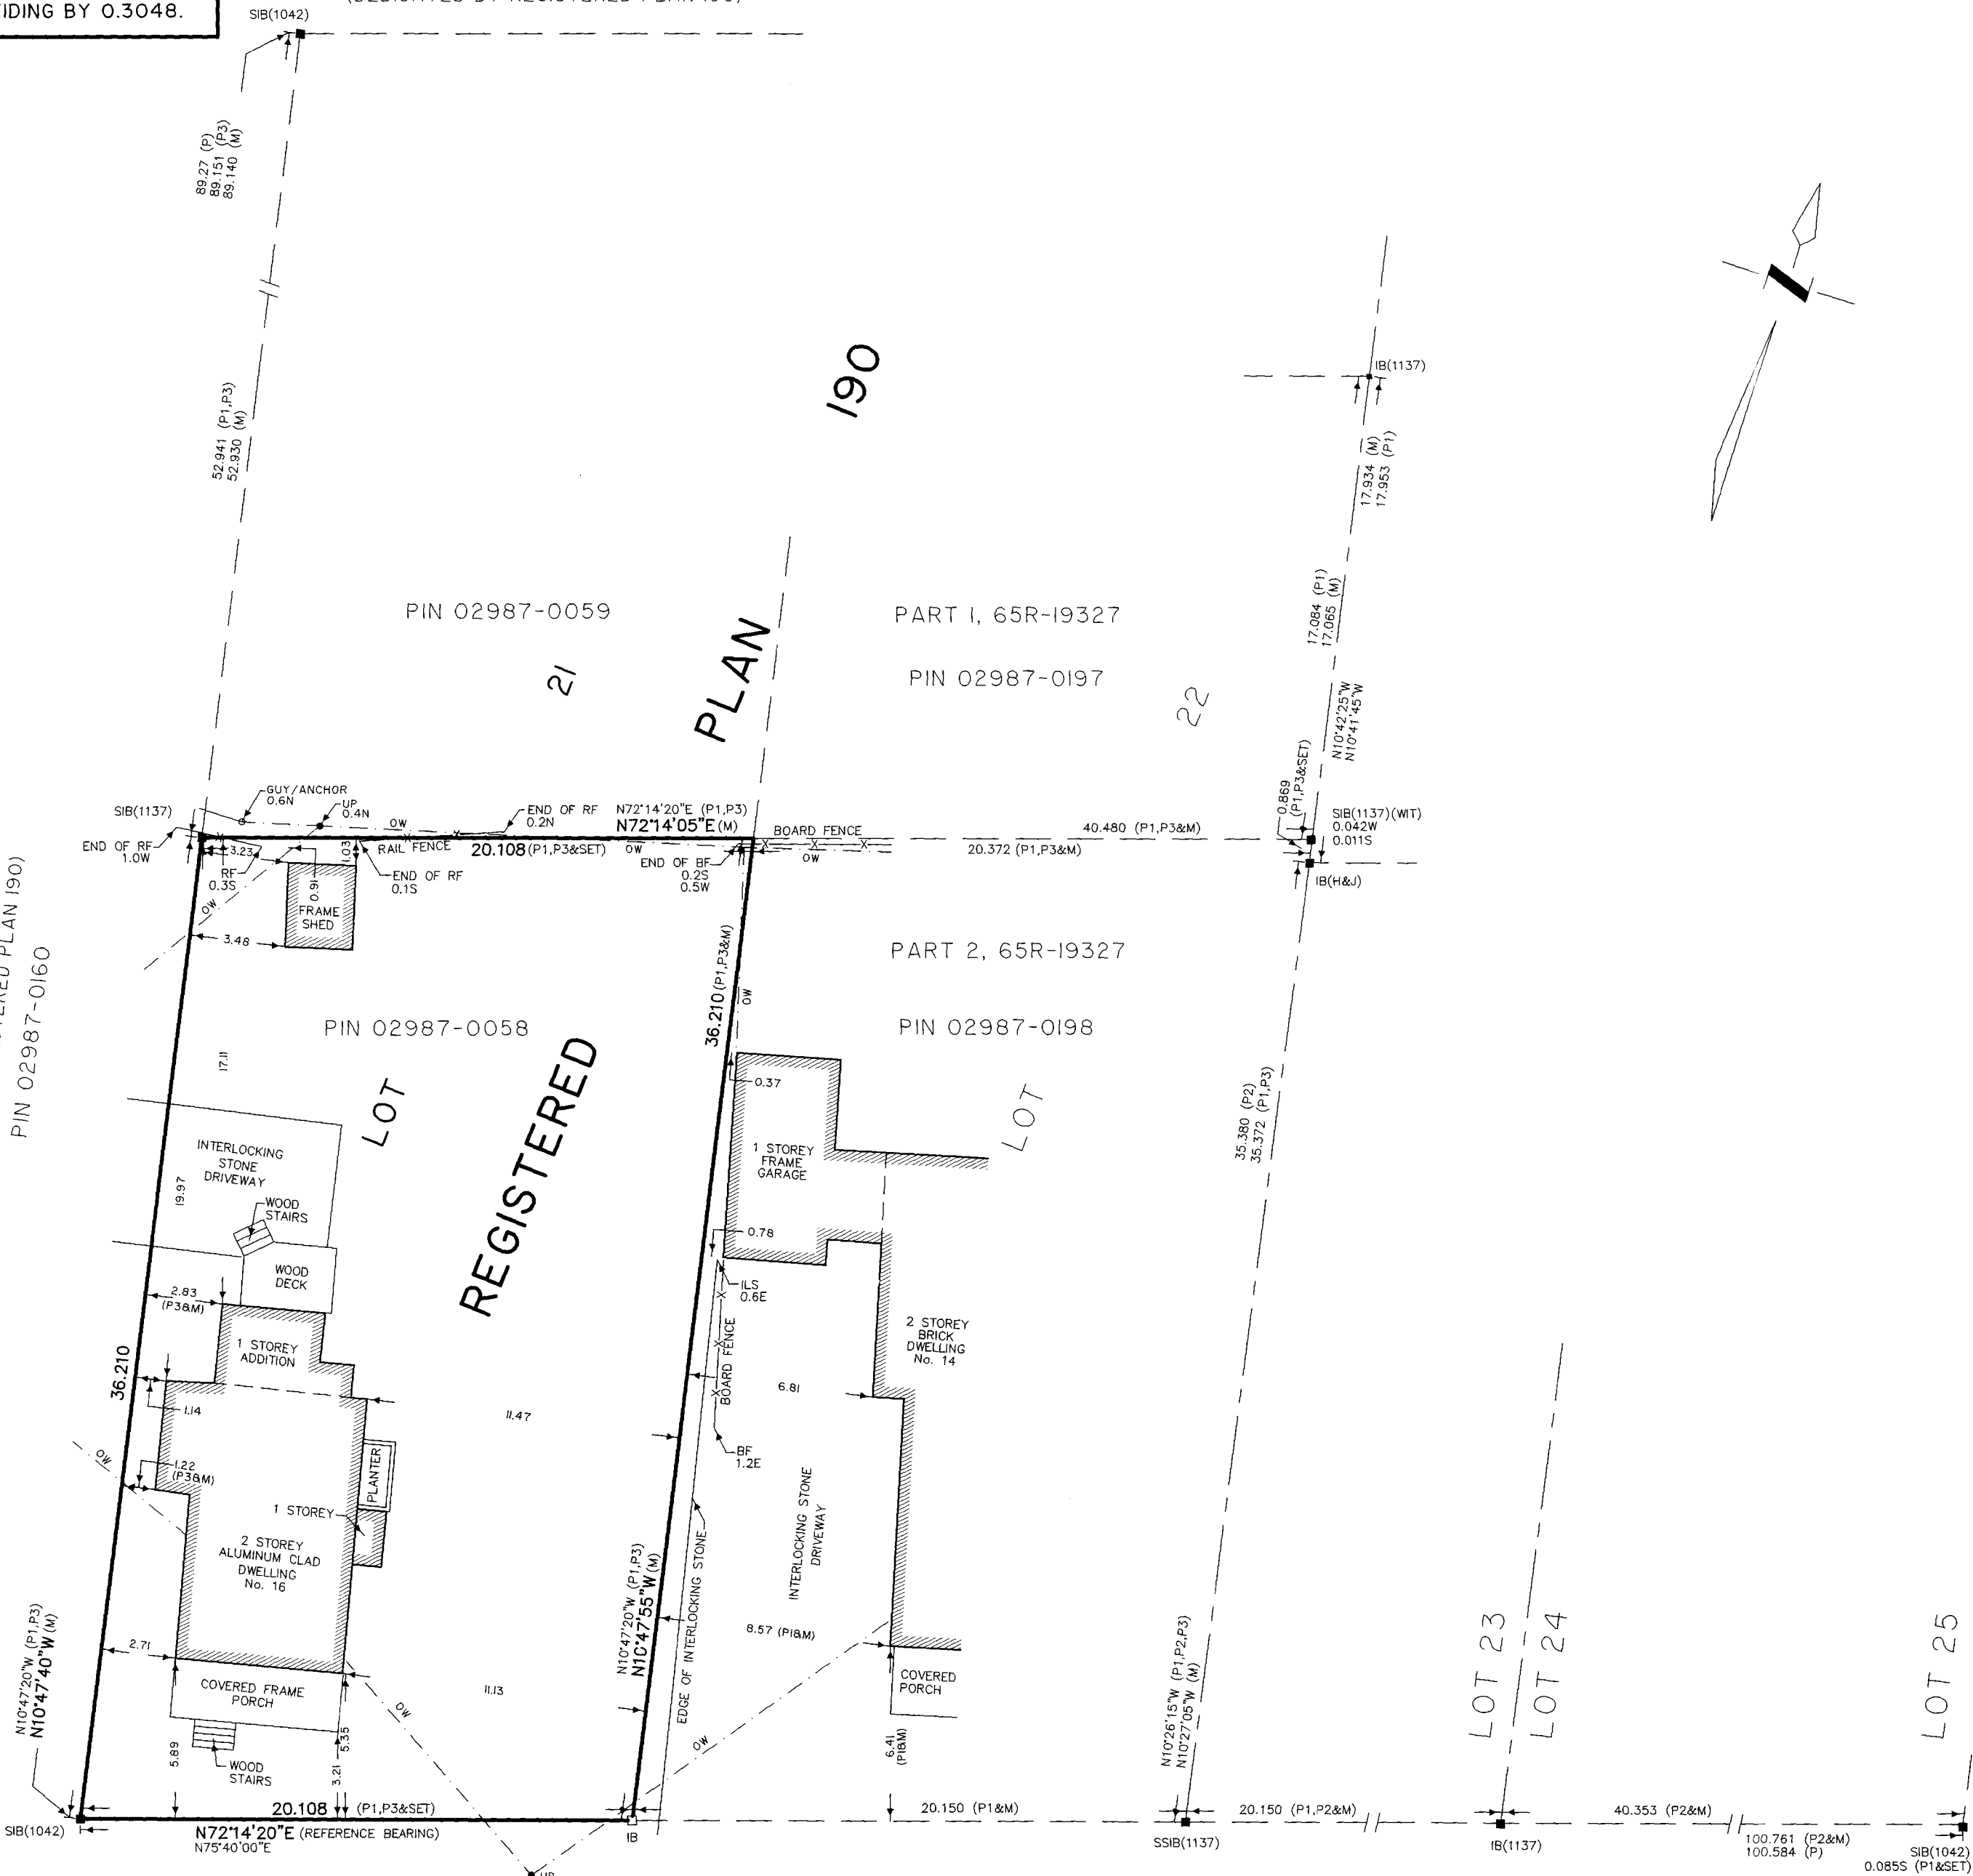

PAVILLION STREET

(DEDICATED BY REGISTERED PLAN I90)

PIN 02987-0166